DRAWING MADE IN THIRD ANGLE PROJECTION

THIS DRAWING IS UNPUBLISHED. RELEASED FOR PUBLICATION , 19 .

© COPYRIGHT 1962 BY AMP INCORPORATED, HARRISBURG, PA. ALL INTERNATIONAL RIGHTS RESERVED. AMP PRODUCTS MAY BE COVERED BY U.S. AND FOREIGN PATENTS AND/OR PATENTS PENDING.

P	F	ZONE	LTR	DESCRIPTION	DATE	APPROVED
	✓		H	REDRAWN & ADDED -8,-4 7497	11-13-81	OK
	✓		J	REVISED PLATING TGG5108		
K	✓		K	REVISED MS. 7818.	2-82	
J	✓		L	REVISED PER AD1327	7-23-86	cp/NOR 8/5/87
✓	✓		M	REV PER AD 1735	722-87	LEW
✓			N	OBS-3 ECN 0699-93	7-93	RAC
✓	✓		P	REV PER EC 0320-349-97	25 NOV 97	NS
			P1	REVISED PER ECO-09-025273	16NOV09	AEG

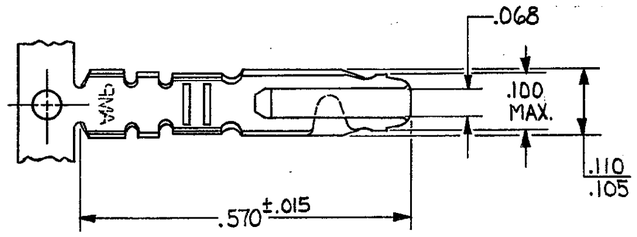

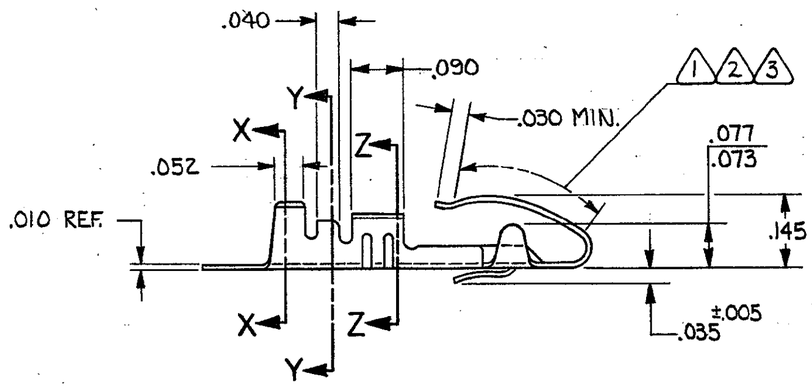

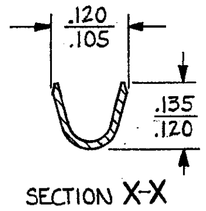

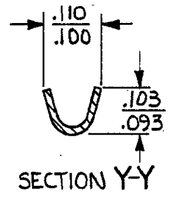

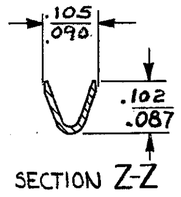

1. .000030 GOLD OVER NICKEL IN CONTACT AREA, REMAINDER OF CONTACT GOLD FLASH.
2. .000015 GOLD OVER .000050 NICKEL IN CONTACT AREA, REMAINDER OF CONTACT GOLD FLASH.
3. .000030 GOLD OVER .000050 NICKEL IN CONTACT AREA, REMAINDER OF CONTACT NICKEL PLATED.
4. WIRE RANGE #22-#18
   INSULATION RANGE .055-.080
5. OBSOLETE PARTS: OBSOLETE CIS STREAMLINING PER D.RENAUD/D.SINISI

	REVERSE REEL PART NO.	FINISH	MATERIAL	PART NO
OBSOLETE	~~60030-7~~	~~3~~	~~PHOS. BRONZE~~	~~60030-6~~
	~~60030-8~~	2	PHOS. BRONZE	60030-4 5
SUPERCEDED	60030-5	1	~~PHOS. BRONZE~~	~~60030-3~~

UNLESS OTHERWISE SPECIFIED DIMENSIONS ARE IN INCHES.
TOLERANCES ON:
DECIMALS ±.010
ANGLES ±

MATERIAL: SEE CHART

FINISH: 1 2 3

CONTRACT NO

DR Debra Kelly 11-13-81

CHK Ray J.

APPD Ray Johnston 11-18-81

APPD [illegible] 11-18-81

DSGN APPD

OTHER APPD

AMP | AMP INCORPORATED Harrisburg, Pa. 17105

NAME

AMP LEAF CONTACT

SIZE	FSCM NO	DRAWING NO
C	00779	60030

SCALE 5-1 SHEET 1 OF 1

AMP 1471-6 REV 2-81

CUSTOMER DRAWING