THIS DRAWING IS UNPUBLISHED. RELEASED FOR PUBLICATION - ,- .
© COPYRIGHT 2005 By - ALL RIGHTS RESERVED.

LOC	DIST
AD	00

REVISIONS

P	LTR	DESCRIPTION	DATE	DWN	APVD
	Z	REVISED PER ECR-12-010535	18DEC2012	M.Y	A.C

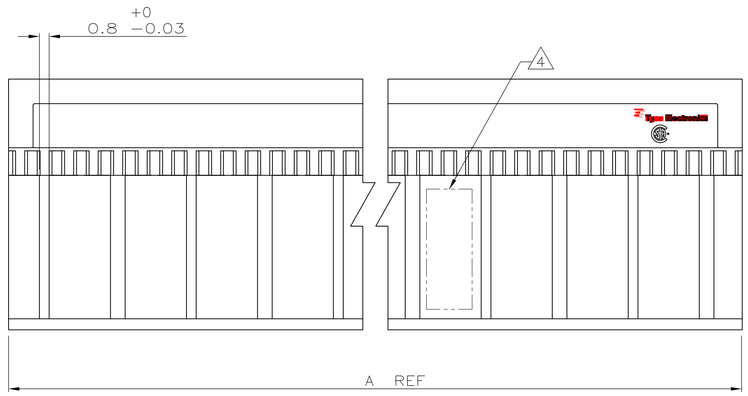

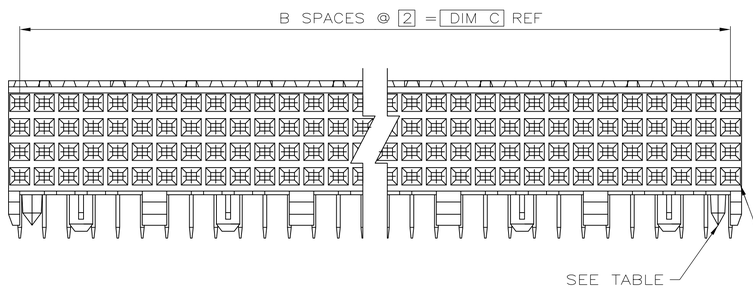

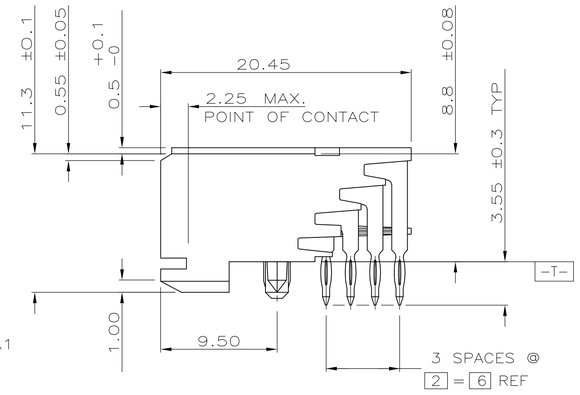

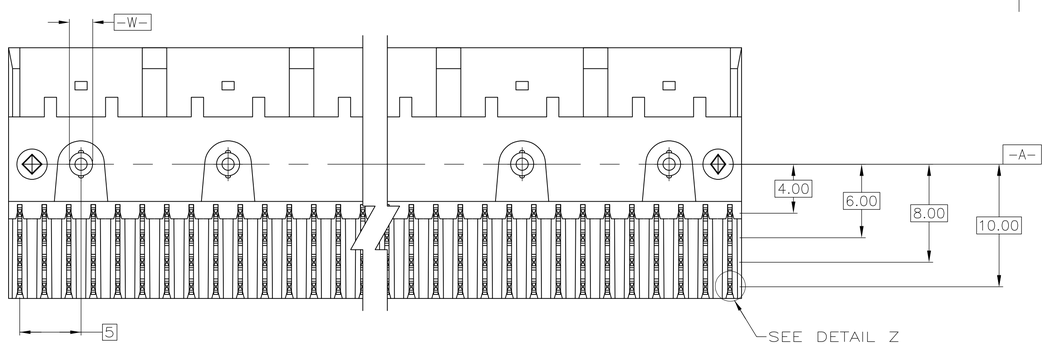

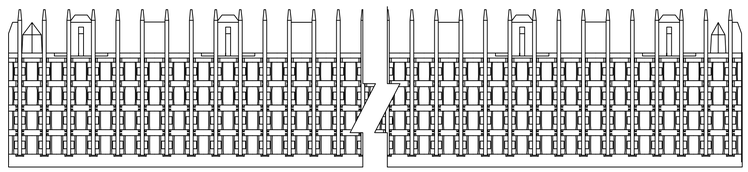

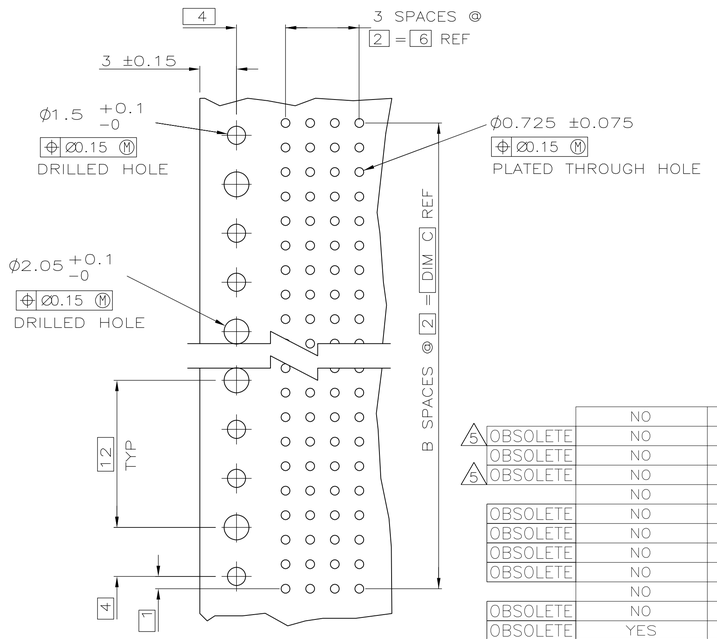

RECOMMENDED CIRCUIT PATTERN
PER IPC-D300 TYPE II, CLASS C
(COMPONENT SIDE)

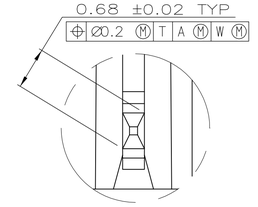

DETAIL Z
SCALE 20:1

1. HOUSING MATERIAL: LIQUID CRYSTAL POLYMER PER ASTM D5138 LCP000 G30A 32250, COLOR: NATURAL.
2. CONTACT MATERIAL: PHOSPHOR-BRONZE.
3. CONTACT FINISH:
   UNDERPLATE (ENTIRE CONTACT) -
   0.00127 MIN. NICKEL
   ON MATING SURFACES-
   CONFORMS TO ALL TESTING SPECIFIED FOR TELCORDIA
   UNCONTROLLED ENVIRONMENT
   ON LEADS-
   0.0006 MIN. TIN-LEAD, OVER UNDERPLATE
   LUBRICATION (ENTIRE CONTACT)
   SURFACE CONDITIONER PER TE CONNECTIVITY SPEC 112-1002 AFTER PLATING.
4. PART MARKING PER AMP INCORPORATED SPECIFICATION 115-9009, LOCATED APPROXIMATELY AS SHOWN.
5. OBSOLETE PARTS: OBSOLETE CIS STREAMLINING PER D.RENAUD/D.SINISI

	POSITIONING PEGS	C	B	A	FINISH	NO OF POSN	PART NUMBER
	NO	34	17	35.88	3	72	1-536511-2
5 OBSOLETE	NO	130	65	131.88	3	264	~~1-536511-1~~
5 OBSOLETE	NO	106	53	107.88	3	216	1-536511-0
5 OBSOLETE	NO	118	59	119.88	3	240	~~536511-9~~
	NO	82	41	83.88	3	168	536511-8
OBSOLETE	NO	66	33	67.88	3	136	536511-7
OBSOLETE	NO	58	29	59.88	3	120	536511-6
OBSOLETE	NO	70	35	71.88	3	144	536511-5
OBSOLETE	NO	94	47	95.88	3	192	536511-4
	NO	46	23	47.88	3	96	536511-3
OBSOLETE	NO	22	11	23.88	3	48	536511-2
OBSOLETE	YES	10	5	11.88	3	24	536511-1

THIS DRAWING IS A CONTROLLED DOCUMENT.

DIMENSIONS: mm

TOLERANCES UNLESS OTHERWISE SPECIFIED:
0 PLC ± -
1 PLC ± -
2 PLC ± .13
3 PLC ± -
4 PLC ± -
ANGLES ± -

MATERIAL 1 2
FINISH 3

DWN D.R.BENDER 10/15/92
CHK S.HEADER 03/29/93
APVD D. RAECHTLE 03/29/93
PRODUCT SPEC —
APPLICATION SPEC —
WEIGHT —

TE Connectivity

NAME RCPT. ASS'Y., SIGNAL MODULE, Z-PACK 2mm FB 4 ROW, 3.55mm PRESS FIT LEAD LENGTH -

SIZE	CAGE CODE	DRAWING NO	RESTRICTED TO
A1	00779	C-536511	—

CUSTOMER DRAWING | SCALE 4:1 | SHEET 1 OF 1 | REV Z