THIS DRAWING IS UNPUBLISHED. RELEASED FOR PUBLICATION -,- .
© COPYRIGHT - By, - ALL RIGHTS RESERVED.

REVISIONS					
P	LTR	DESCRIPTION	DATE	DWN	APVD
	B1	REVISED PER ECO-15-006874	15NOV2015	AP	MH

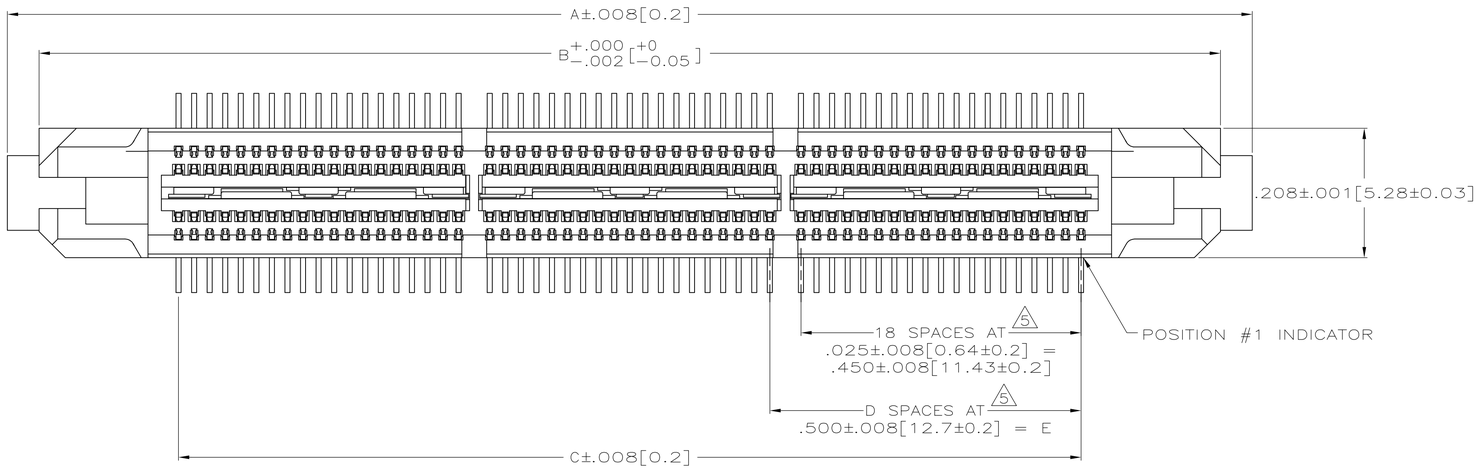

1. HOUSING: LIQUID CRYSTAL POLYMER, COLOR BLACK. CONTACTS: HIGH RELIABILITY COPPER ALLOY. GROUND BUSSES: BRASS.
2. CONTACTS & GROUND BUSES: NICKEL UNDERPLATE ALL OVER, MATING SURFACE PLATED TO MEET LEVEL 1 PERFORMANCE REQUIREMENTS OF TE PRODUCT SPECIFICATION 108-1422, SOLDER TAILS PLATED MATTE TIN.
3. DATE CODE MARKED IN AREA INDICATED ON SAME SIDE AS POSITION #1.
4. ONE GROUND BUS WITH 5 TAILS PER EACH MODULE.
5. TOLERANCE NON-ACCUMULATIVE.
6. FOR STANDARD APPLICATIONS, ORIENTATION HOLE TO BE ϕ.094±.002[2.39±0.05].
   FOR SLIP-FIT APPLICATIONS, ORIENTATION HOLE TO BE ϕ.079±.001[2.00±0.03].

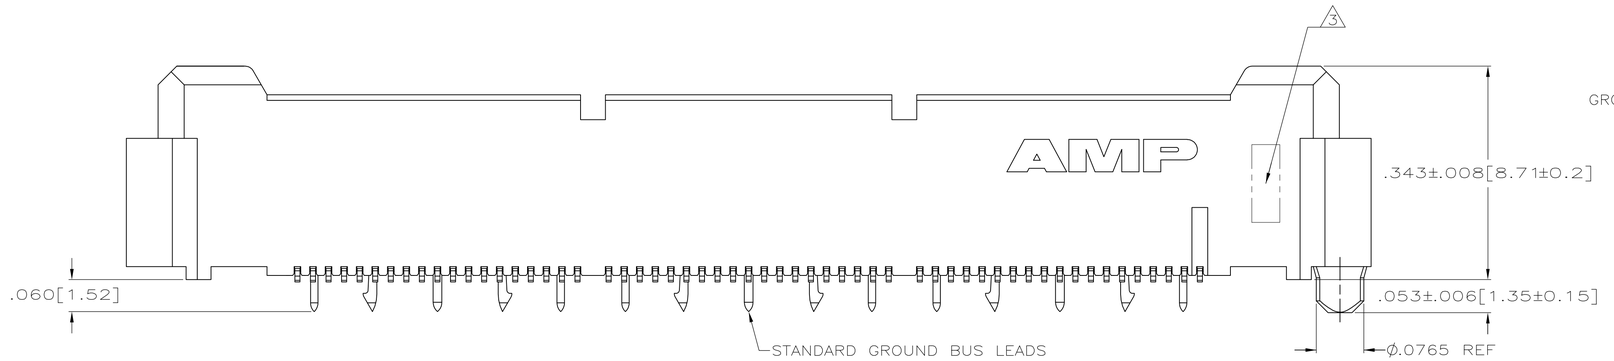

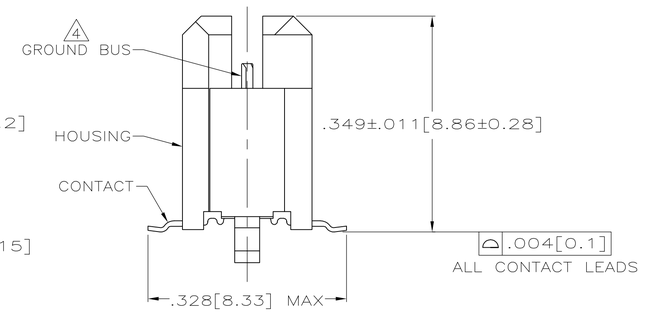

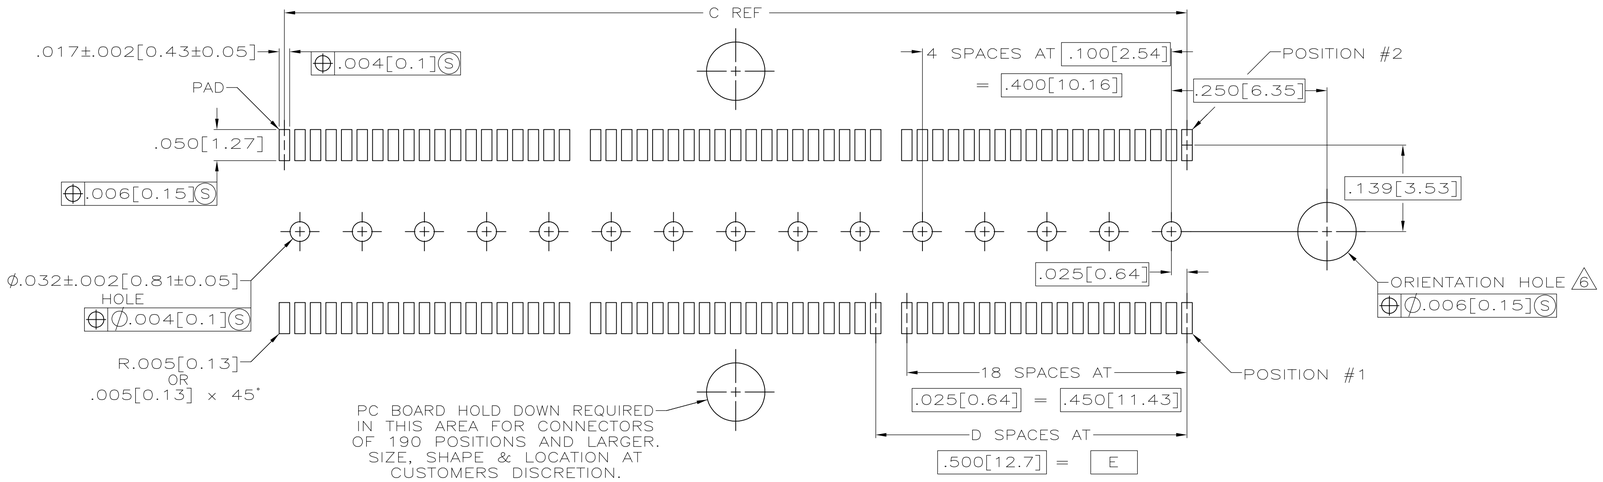

RECOMMENDED PC BOARD LAYOUT
(VIEWED FROM CONNECTOR SIDE)

	E	D	C	B	A	NO OF POS	PART NUMBER
OBSOLETE	~~3.000[76.2]~~	~~6~~	~~3.450[87.63]~~	~~3.898[99]~~	~~4.000[101.6]~~	~~266~~	~~5767139-7~~
	~~2.500[63.5]~~	~~5~~	~~2.950[74.93]~~	~~3.398[86.31]~~	~~3.500[88.9]~~	~~228~~	~~5767139-6~~
	~~2.000[50.8]~~	~~4~~	~~2.450[62.23]~~	~~2.898[73.61]~~	~~3.000[76.2]~~	~~190~~	~~5767139-5~~
	~~1.500[38.1]~~	~~3~~	~~1.950[49.53]~~	~~2.398[60.91]~~	~~2.500[63.5]~~	~~152~~	~~5767139-4~~
	~~1.000[25.4]~~	~~2~~	~~1.450[36.83]~~	~~1.898[48.21]~~	~~2.000[50.8]~~	~~114~~	~~5767139-3~~
	.500[12.7]	1	.950[24.13]	1.398[35.51]	1.500[38.1]	76	5767139-2
	.000[0]	0	.450[11.43]	.898[22.81]	1.000[25.4]	38	5767139-1

THIS DRAWING IS A CONTROLLED DOCUMENT.

DIMENSIONS: INCHES

TOLERANCES UNLESS OTHERWISE SPECIFIED:
0 PLC ± –
1 PLC ± –
2 PLC ± –
3 PLC ± .005[0.13]
4 PLC ± –
ANGLES ± –

MATERIAL 1

FINISH 2

DWN	G. ATTADIA	28 OCT 04
CHK	D. DIXON	28 OCT 04
APVD	D. DIXON	28 OCT 04

TE Connectivity

NAME: PLUG ASSEMBLY, .354[9.00] VERTICAL, .025[0.64]CL, GULL WING LEADS, MICTOR

PRODUCT SPEC: 108-1422
APPLICATION SPEC: 114-11004
WEIGHT: –

SIZE	CAGE CODE	DRAWING NO	RESTRICTED TO
A1	00779	C-5767139	–

CUSTOMER DRAWING | SCALE 8:1 | SHEET 1 OF 1 | REV B1